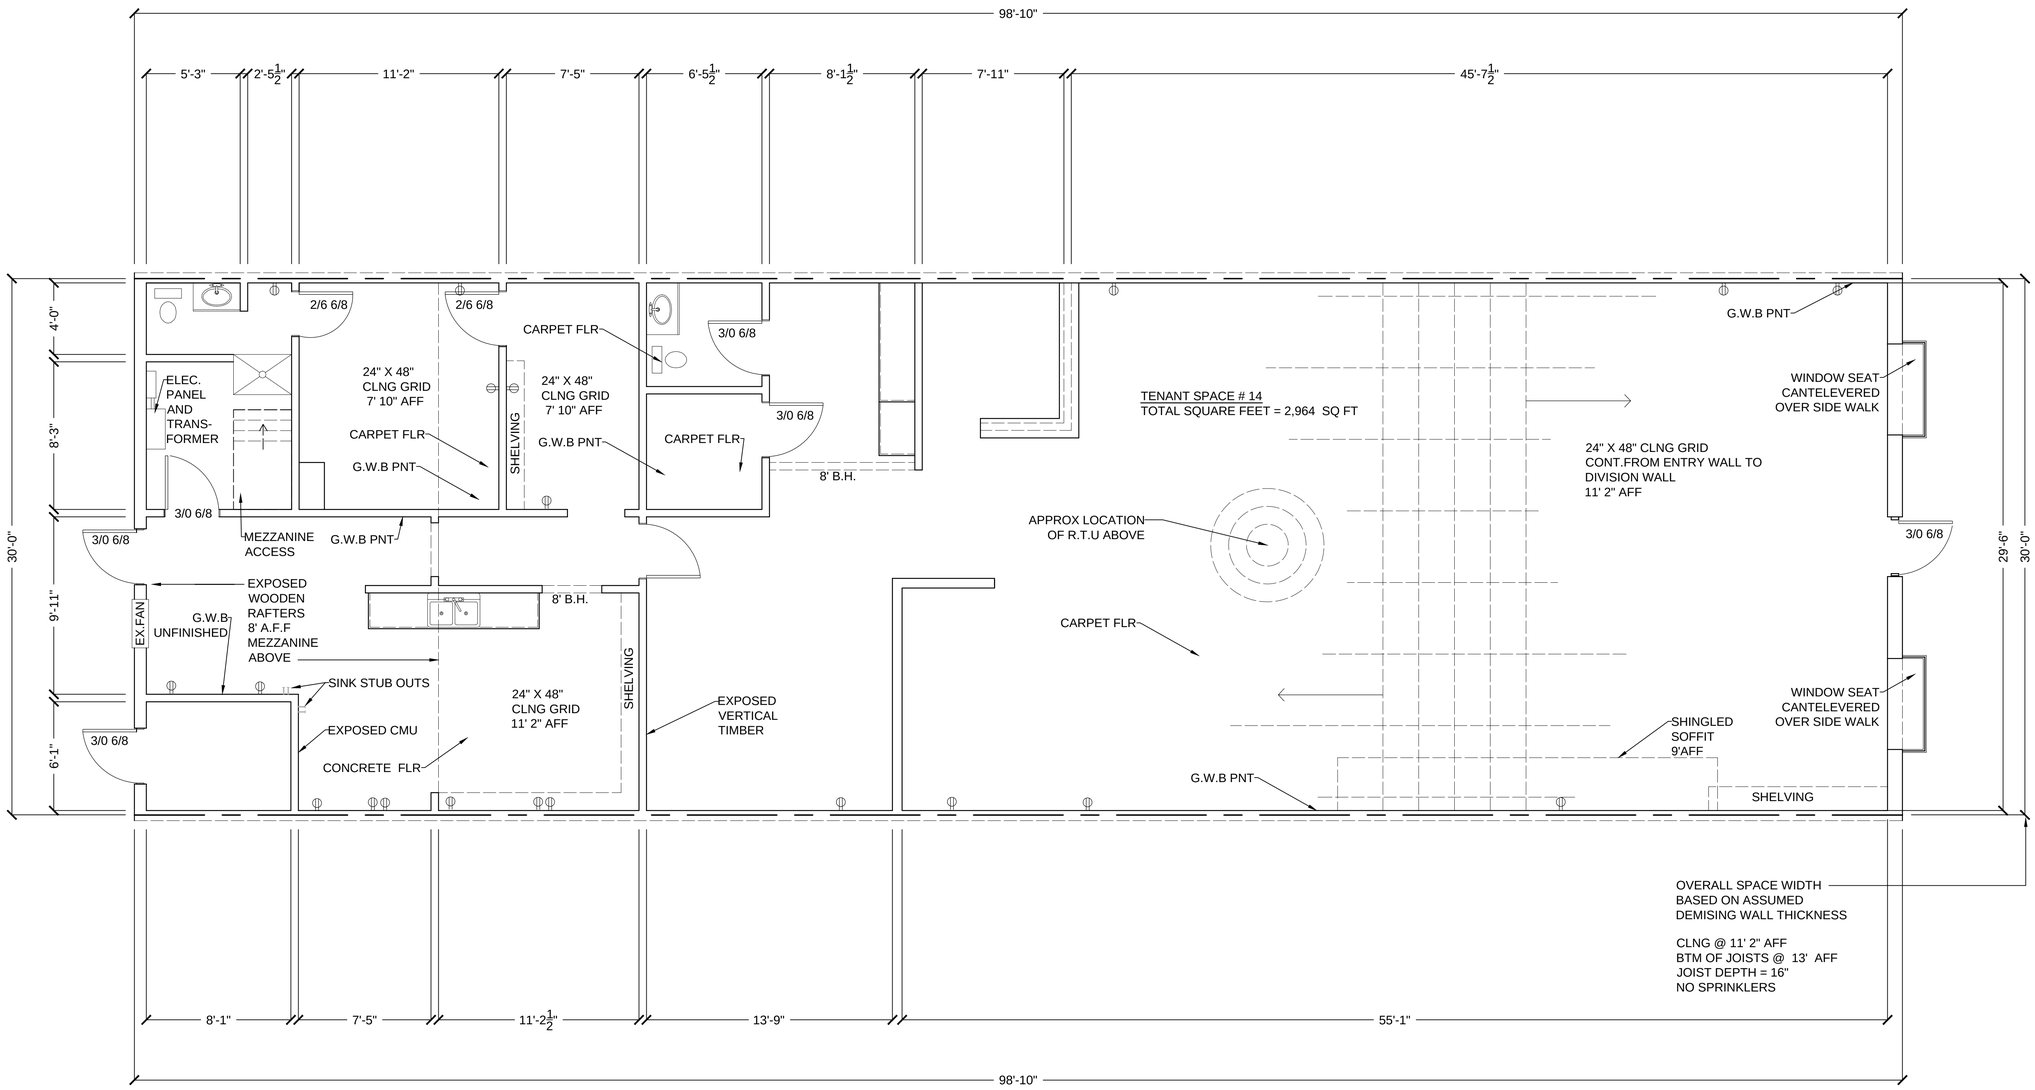

1 FLOOR PLAN (SPACE #14)

Scale: 1/4" = 1"

NOTES

ALL DIMENSIONS ARE GENERAL IN NATURE TAKEN FROM FIELD NOTES. DIMENSIONS ARE FROM FINISH TO FINISH UNLESS OTHERWISE NOTED. NEW TENANT TO VERIFY ALL DIMENSIONS.

ELECTRICAL SCHEDULE

- DUPLEX OUTLET
- DOUBLE DUPLEX OUTLET
- PHONE JACK
- THERMOSTAT
- EMERGENCY LIGHT FIXTURE
- EXIT SIGN

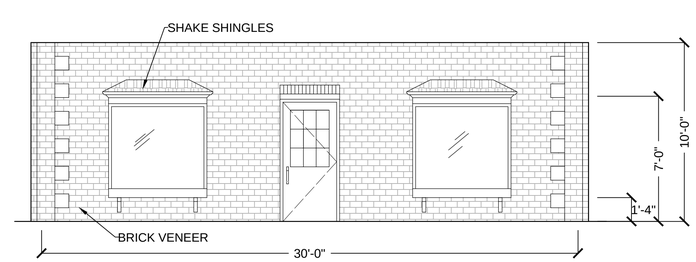

2 STOREFRONT ELEVATION

Scale: 1/4" = 1"

GOODWYN | MILLS | CAWOOD
2660 EastChase Lane, Suite 200 | Montgomery, AL 36117
Tel 334.271.3200 | GMCNETWORK.COM

ISSUE DATE

AS-BUILTS	2-25-10
REVISIONS	3-08-10
drawn by:	
checked by:	

3700 PEPPERELL PARKWAY
AS BUILT DRAWINGS
OPELIKA, AL

M2010

AS BUILTS

STATE OF ALABAMA
NOT FOR CONSTRUCTION USE
FOR DESIGN ONLY
REGISTERED ARCHITECT
Mississippi
Alabama

TENANT SPACE # 14

A1.01

sheet of